


Pcl A  
(DD 193491)

AS-BUILT SITE PLAN  
RUBY ALTON HOUSE  
ISLANDS TRUST FUND  
RAINWATER HARVESTING  
DEMONSTRATION PROJECT  
JULY 12, 2005

F U L F O R D



2  
4  
3  
3  
9  
4  
4  
P I a n  
ISABELLA

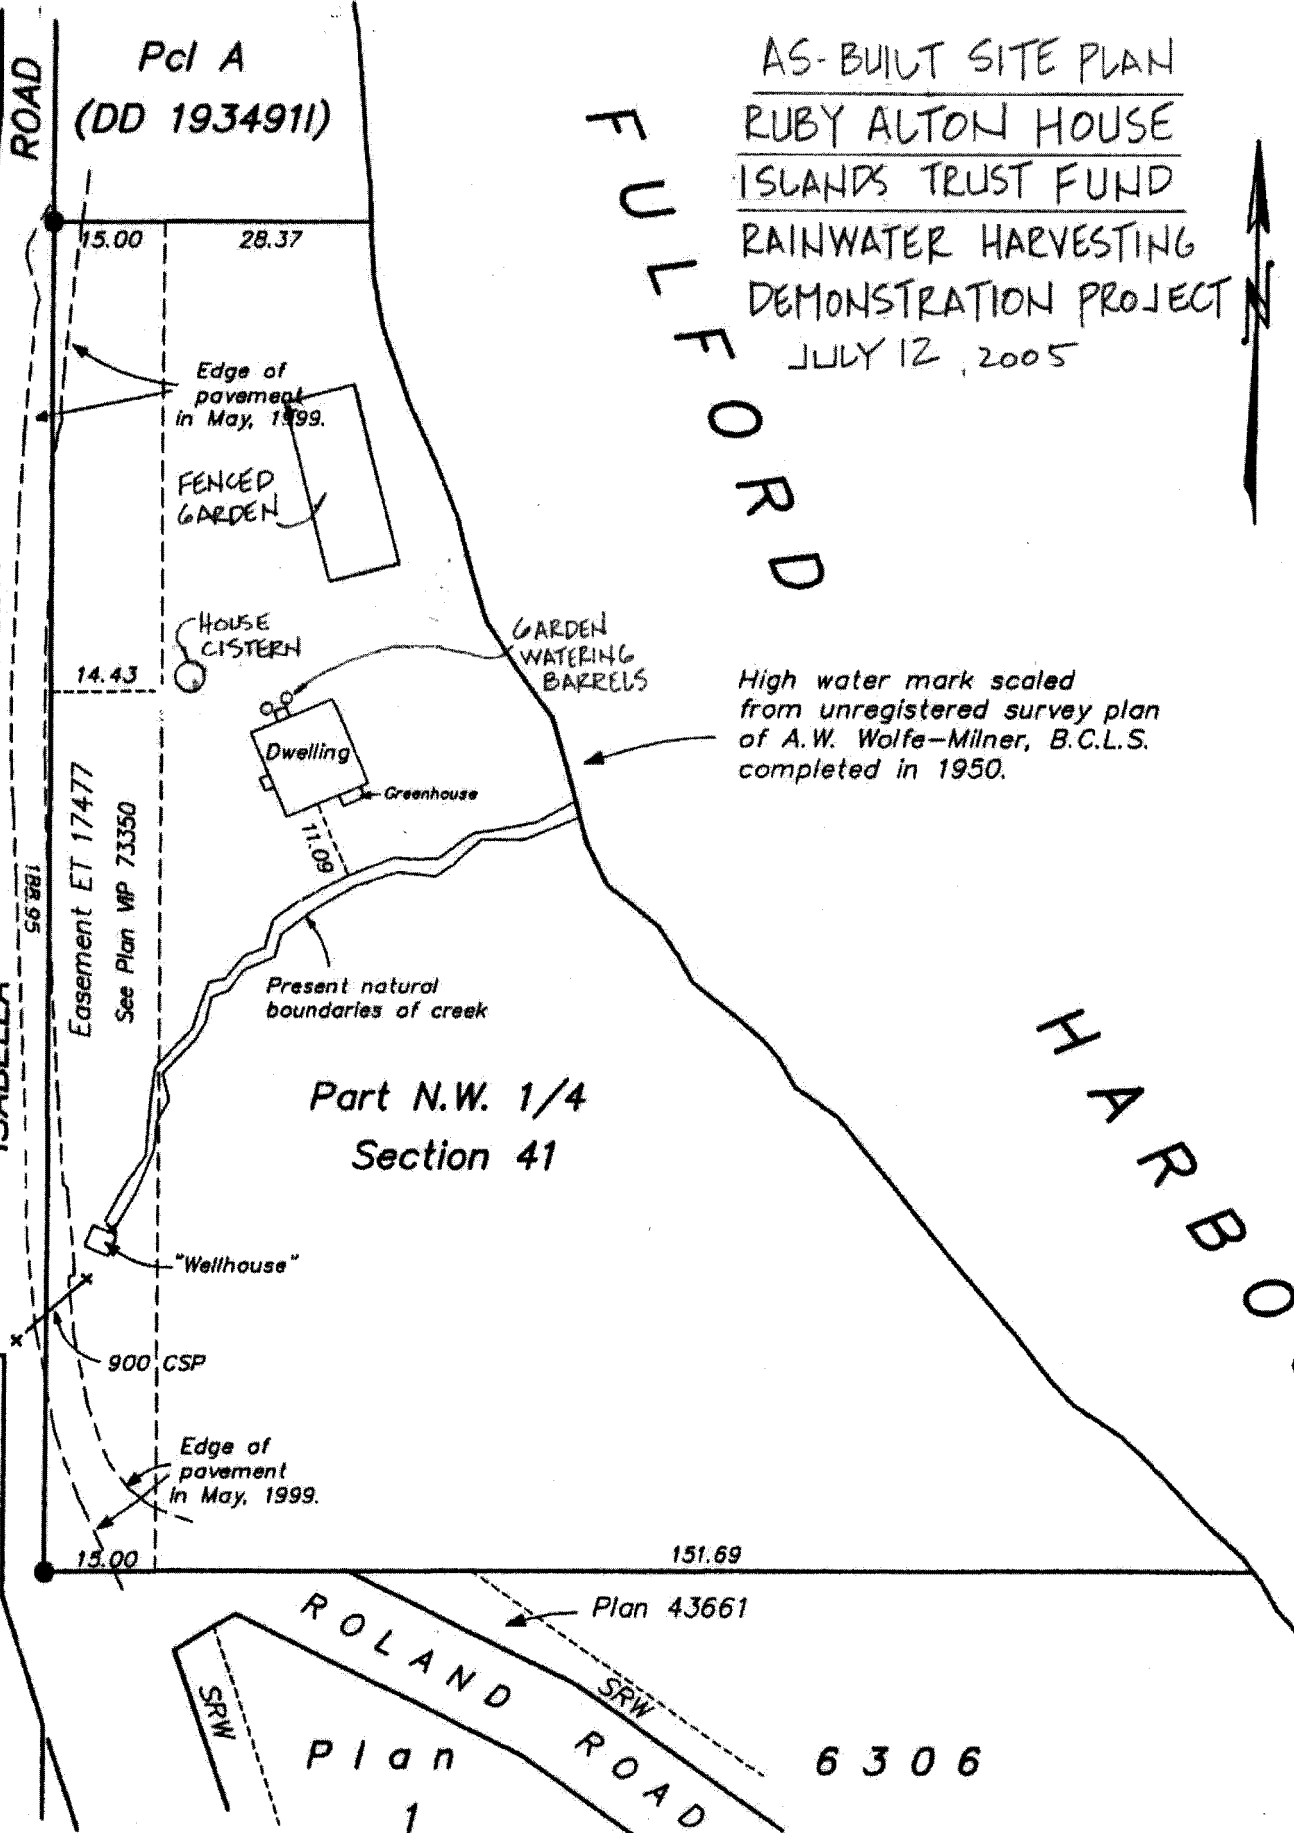

High water mark scaled  
from unregistered survey plan  
of A.W. Wolfe-Milner, B.C.L.S.  
completed in 1950.

Part N.W. 1/4  
Section 41

H A R B O U R

15.00 28.37

14.43

Easement ET 17477  
See Plan MP 73350

11.09

15.00

151.69

Plan 43661

2716

6306

