


AS-BUILT PLAN OF RAINWATER CATCHMENT SYSTEM

RUBY ALTON HOUSE

ISLANDS TRUST FUND
RAINWATER HARVESTING
DEMONSTRATION PROJECT

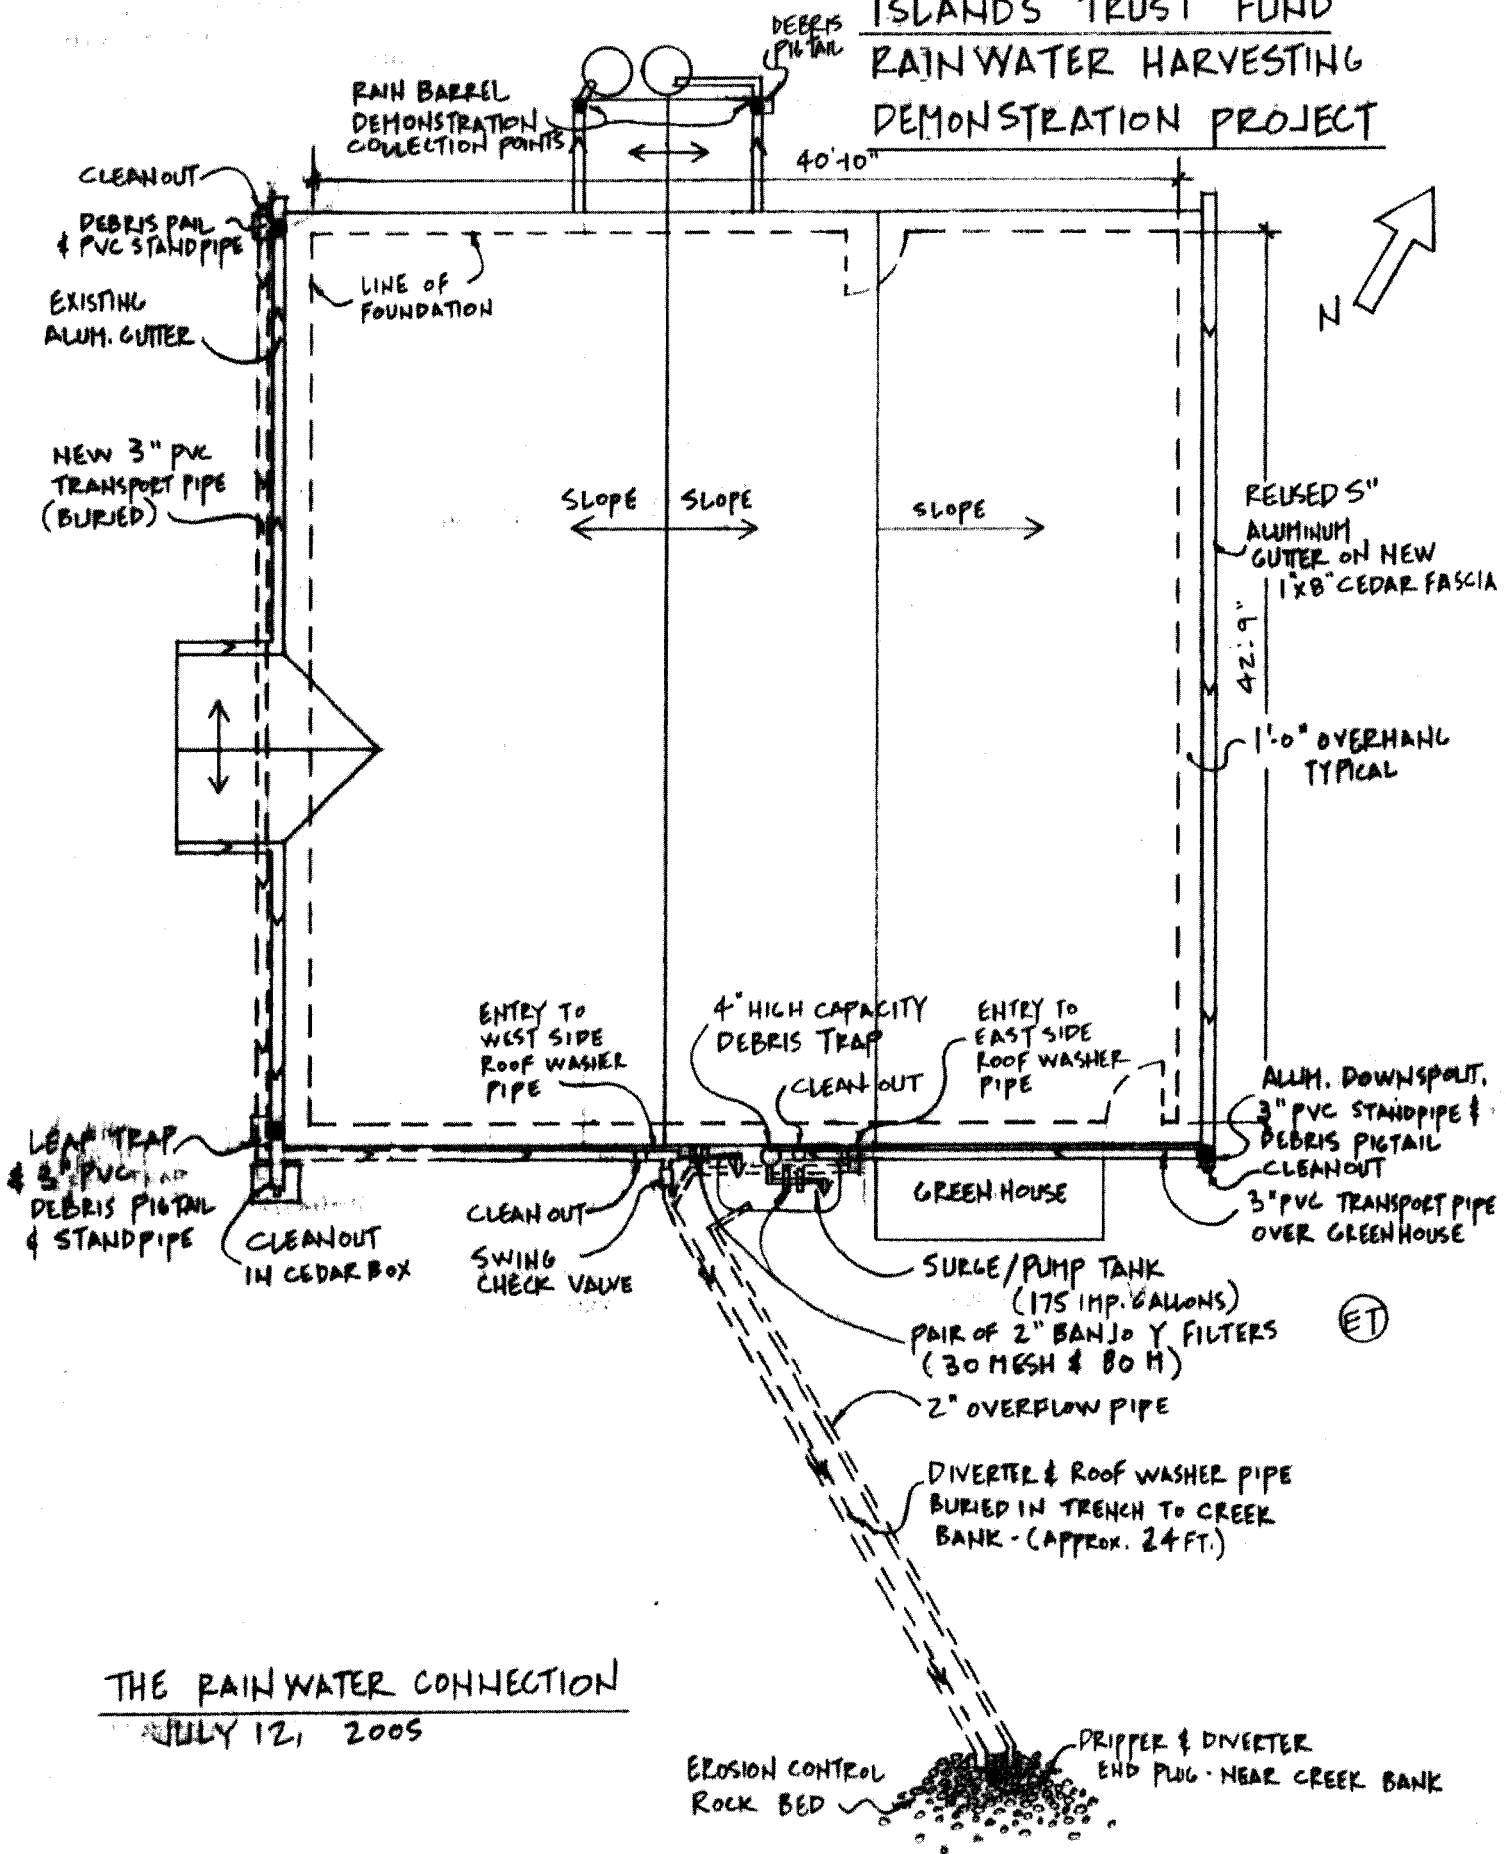

THE RAINWATER CONNECTION

JULY 12, 2005

EROSION CONTROL
ROCK BED
RIPPER & DIVERTER
END PLUG - NEAR CREEK BANK